

RECORD OF INSPECTION-SEWAGE DISPOSAL SYSTEM

Date 6/6/73 Case No. _____

Owner AYLOR, MRS. ELVA Address REVA, VA. Phone _____
 (Mailing Address)
 Occupant SAME Address _____ Phone _____
 (Mailing Address)

Exact Location of Premises RT. 29 NORTH. LEFT ON RT. 609. GO 3.1 MILES ON LEFT AT POWER SUBSTATION. GO UP HILL
 (Subdivision, Street or Road Name, Section or Lot No.)

PROPERTY ON LEFT.

WATER SUPPLY INSPECTION

Installed according to Permit Design ☐ Yes ☐ No. Distance to nearest House Sewer _____ feet. Distance to nearest Sewage Disposal System _____ feet. (Use Form LHS-143 for Detailed inspection of Water Supply Reference Materials.)

SEWAGE DISPOSAL SYSTEM INSPECTION

(1) LOCATION

Allotted Area adequate ☐ Yes ☐ No. Distance from nearest lot lines _____ feet. Trees _____ feet. Water Supplies _____ feet. Buildings 6 feet.

(2) INSTALLATION AND DESIGN

Installed according to Permit Design ☒ Yes ☐ No. Have additional Household Appliances been added NOT on Permit: ☐ Automatic Washer ☐ Garbage Disposal ☐ Other NONE
 (Describe)

(3) SOIL CONDITION

Are there soil conditions now evident which indicate system may be unsatisfactory as designed: ☐ Yes ☐ No. If Yes, show adjustments required under "Remarks" below.

(4) HOUSE SEWER LINE

Installed ☒ Yes ☐ No. Type of material PLASTIC Size 4 Inches.

(5) SEPTIC TANK

Constructed of CONCRETE
 (Kind of Material)
 Inside Dimensions Length 7 feet. Width 3 1/2 feet. Liquid Depth 4 feet. Depth of Air Space 12 inches. Inside Fittings comply with requirements ☐ Yes ☐ No.

(6) DISTRIBUTION BOX

Watertight and equal surcharge to each line by Water Test ☒ Yes ☐ No. Distribution Box provided with 2 (Number) extra outlets for future use.

(7) SUBSURFACE ABSORPTION FIELD

Total Area in bottom of ditches 800 square feet. Number of ditches 4 Length of ditches 100 feet. Grade of ditches Minimum 4 Inches per 100 feet. Maximum 5 inches per 100 feet. Has system been checked by instruments (Level) ☒ Yes ☐ No. Type aggregate used GRAVEL Depth of aggregate under Tile 6 inches. Total depth of aggregate 13 inches. Depth of backfill over aggregate 18+ inches.

(8) SURFACE DRAINAGE

Storm Drains from House and Basement flowing away from Subsurface Drainage Field: ☒ Yes ☐ No. Was Surface Drainage required ☐ Yes ☐ No. If Yes, has this been provided ☐ Yes ☐ No. Has area been drained by lowering Ground Water Table: ☐ Yes ☐ No. ☒ Not required.

(9) Are follow-up inspections necessary ☐ Yes ☒ No.

Septic Tank Contractor MADISON EXCAVATING CO. Address ROCHELLE, VA. Phone _____

This Sewage Disposal System (Is) (I ☒) Approved by MADISON CO. Health Department.

Date 6/7/73 Signed C. A. Richardson (Sanitarian) Date _____ Approved _____ (Health Director)

Date _____ Approved _____ (Advisory Sanitarian) Date _____ Approved _____ (Reviewing Authority — Other Agency)

With proper maintenance, approved Sewage Disposal systems may be expected to function satisfactorily, provided no overloading or physical damage occurs to the system. Remarks: _____

PERMIT TO INSTALL ☒ REPAIR, ☐ REASONS FOR REJECTION ☐
WATER SUPPLY ☐ SEWAGE DISPOSAL SYSTEM ☒

SEC-24
PROP-30
GRID-~~30~~
I 13

(1) Void after (12) twelve months. (2) Automatically cancelled when site conditions are changed from those shown on permit.
(3) Automatically cancelled should facts later become known that a potential hazard would be created by continuing installation.

FHA/VA ☐ Yes ☐ No Date 11/14/72 Case No. GR10-30

Owner MRS. ELVA AYLER Address REVA, VA. Phone 948-2387
(Mailing Address)

Occupant SEME Address _____ Phone _____
(Mailing Address)

Exact Location of premises RT. 29 NORTH, LEFT ON RT. 609—GO 3.1 MILES ON LEFT @ POWER SUBSTATION—GO UP HILL
(Subdivision, Street or Road Name, Section or Lot No.) PROPERTY ON LEFT

FOR: ☐ Dwelling ☐ Other TRAILER Automatic Washing Machine ☒ Yes ☐ No Consumption 405 gal. per day
Actual ☒ Potential ☐ Bedrooms 3 Garbage Disposal Unit ☐ Yes ☒ No (☐ Actual ☒ Estimated Water)
Additional wastes _____

(1) WATER SUPPLY (Existing) Class _____ Approved ☐ Yes ☐ No Other RECOMMEND DRILLED WELL CASED TO ROCK WITH CEMENT SLURRY GROUT TO 20' DEPTH AROUND CASING
(To be installed) Class _____ Cased _____ ft. to be grouted _____ ft.

(Unless supported by positive evidence Class III is to be considered as to be installed.)

(2) SOIL STUDY Naturally drained, suitable by sight ☒ Yes ☐ No Technical Classification _____ (If Known)
Estimated Percolation Rate 1-10 ☐ 11-25 ☐ 26-50 ☐ > 51 ☒ Percolation Test Required ☐ Yes ☒ No Rate _____
(Minutes per inch) (Minutes per inch to nearest 10 minutes)
Depth to Grey Mottles _____ inches (estimate over 4 ft.) OTHER _____
Surface drainage required ☐ Yes ☒ No OTHER DRAINAGE _____

(3) HOUSE SEWER LINE Size 4 inches. Type of material required CI Distance from Water Supply 50 feet.


(4) DETAILS OF CONSTRUCTION Watertight Septic Tank of Concrete Material Liquid Capacity 750 gallons.
Inside Dimensions Length 7 feet. Width 3 1/2 feet. Liquid Depth 4 feet. Depth of Air Space 1 feet.

SUBSURFACE ABSORPTION FIELD Number of square feet required 800 Type aggregate required broken stone
(5) Depth of aggregate from base of tile to bottom of ditches 6 inches. Allowable fall 2 to 4 inches.
Total aggregate minimum depth 13 inches or more. Depth of drainfield to be 30 inches from surface of original ground.
Distance from well to septic tank 50 feet; distance from well to drainfield 100 feet.

Rough Sketch of Premises (including adjacent properties if pertinent, Showing Location of Lot Line, Buildings, Water Supplies, Sewage Disposal System, Trees, and Other Possible Sources of Contamination of Water Supplies, by Indicating Distances and Slope with regard to one another.

NOT TO SCALE

KEEP DRAINFIELD 100' FROM ALL POTABLE WATER SUPPLIES
KEEP DRAINFIELD 50' FROM POND; REMOVE ALL TREES FROM DRAINFIELD AREA
FOOT LINES
SIX FOOT CENTERS
TWO FOOT DITCHES

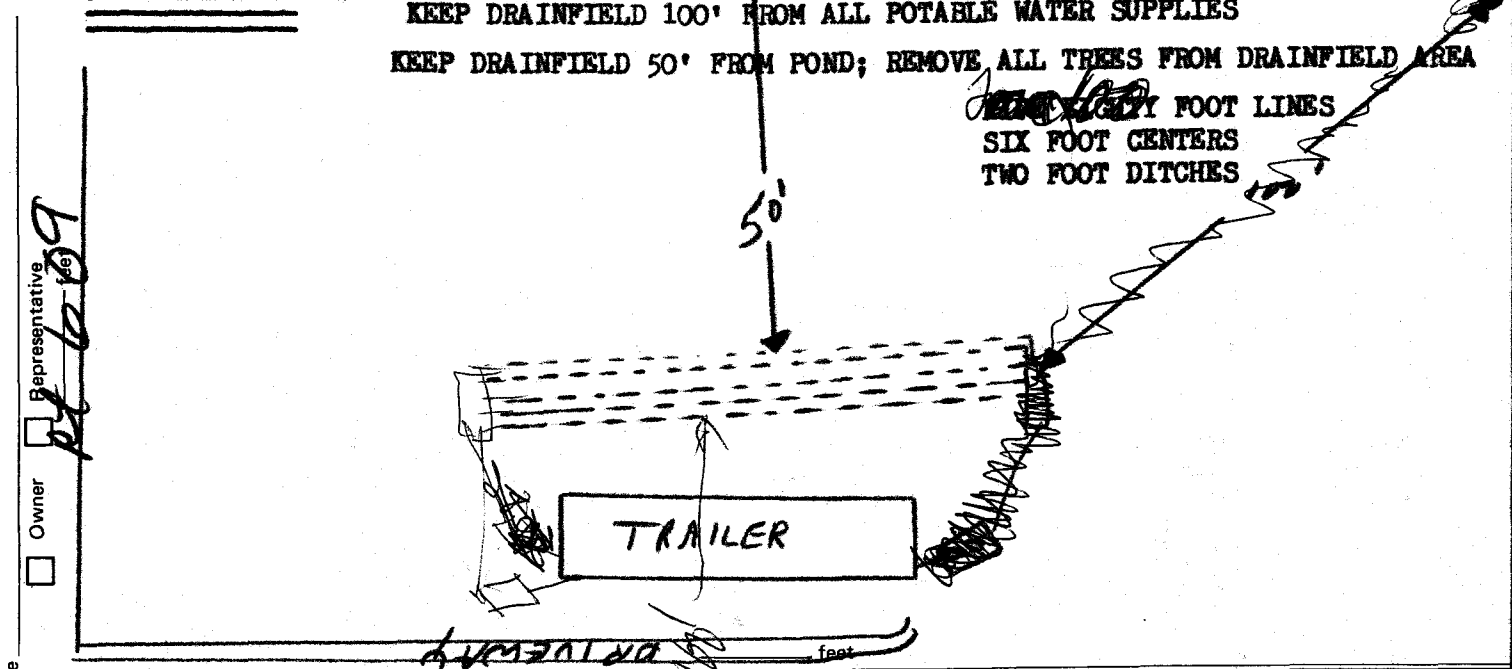

Note: Owner or his agent must notify MADISON CO. Health Department, Phone 948-5481 when installation is ready for inspection. If any Sewage Disposal System, or part thereof, is covered before being inspected by the Health Department, it shall be uncovered at the direction of the Health Director or his agent. CONDITIONS DISCOVERED DURING INSTALLATION MAY REQUIRE ADJUSTMENTS OF SYSTEM DESIGN. Changes from above specifications require Health Department approval before being made.

Based on the above information, the undersigned recommends that this permit be issued. W. A. Dallas T. Huber
Date _____ Approved _____ Date _____ Signed _____
(Reviewing Authority) (Sanitarian or Health Director)

COUNTY OF MADISON, VIRGINIA
OFFICE OF THE ZONING ADMINISTRATOR

District

APPLICATION FOR ZONING & BUILDING PERMIT

Permit No.

INSTRUCTIONS: Prepare FOUR COPIES; Secure approval of Health Department; Submit to Zoning Administrator together with scaled plot plan showing lot dimensions, building location on lot, distance from road front, distance from adjacent owners, building dimensions and building plans.

Name of Owner **Mrs. Elva Aylor**

Address **Reva, Va.** Telephone **948-2387**

Name of Contractor

Address Telephone

Property Location—Highway No. **609** Street Lot No.

Block Section Subdivision Land Map No. **24-31B**

Lot Size **8 acres** Frontage **400 plus Ft.** Depth ☐ Corner ☐ Inside

Zoning Classification **A-1** Classification of Adj. Land **A-1**

BUILDING DATA

Type of Structure **Mobile Home** Proposed Use

☐ New Building ☐ Addition ☒ Mobile Home (Yr. **1972**) Other **Fleetwood**

Size **12** x **65** No. Floors Total Area Square Feet

Units Height Rooms **4** Baths **1** Kitchen **1**

Garbage Disposals Heat (type) **Oil** Basement (☐ full ☐ partial ☐ finished)

Exterior Wall Construction Type Roof & Covering

☐ Garage ☐ Carport ☐ Attached ☐ Detached Size x Total Area Sq. Ft.

If there are any other buildings on the property, attach a sketch indicating location, dimensions, use, type of construction, distance to road and property line.

HIGHWAY DATA, SETBACK, YARDS, PARKING

Frontage Road: Total width of R/W **20 Ft.** Side Road (if any) width

Building Setback: **100** Feet from Frontage Road; Side Yard **25** Feet from **Walter Aylor**

Side Yard **25** Feet from **Thomas Lohn** ADJACENT OWNER; Rear Yard **50** Feet from **T. Broyles** ADJACENT OWNER

Type of Surface Off-Street Parking (No. Cars)

UTILITIES

Domestic Water: ☒ Individual ☐ Public Sewerage: ☒ Individual ☐ Public

Health Permit Approved by Health Dept.
(DATED) (DATE)

Estimated Cost \$ **8300.00** Work to Begin To Be Completed

I hereby certify that I have the authority to make the foregoing application, that the information given is correct, and the use or construction shall conform to the County Health Regulations, the Zoning Ordinance, and private deed restrictions, if any, which are imposed on the above property. I further agree to restore any and all damage which may result from this work.

Signature of
Owner or Agent: **Mrs. Elva Aylor** Date **Nov. 10, 1972**

Approved by Zoning Administrator: Date

73 ¹	75	80	93
70 ¹	71 ¹	78 ¹	90
68 ²	70	76	88
42	5	4	5