

# County of Rutherford

BUILDING CODES DEPARTMENT

Training Center  
898-7891  
State Environmentalists

DAVID H. JONES  
Building Official

DO NOT MOVE  
MOBILE HOME ON  
PROPERTY UNTIL  
BUILDING PERMIT  
is issued.

Year - size  
color value

ROOM 201, #1 SOUTH PUBLIC SQUARE  
MURFREESBORO, TENNESSEE 37130  
PHONE 615/898-7734

## INFORMATION REQUEST

FOR SEWAGE DISPOSAL SYSTEM

Robert S. (Mar & H.) Anderson (Property Owner)

APPLICANT'S NAME: Ralph Dedmon

TELEPHONE NUMBER: HOME: \_\_\_\_\_ WORK: \_\_\_\_\_

ADDRESS OF PROPERTY: (REQUESTING BUILDING PERMIT) \_\_\_\_\_

226 Rehovath Road

TAX MAP: 095 PARCEL: 066-00

APPLICANT IS APPLYING FOR A BUILDING PERMIT TO: place a 3-Bdrm. mobile home on property - existing septic - old mobile home is removed

BUILDING CODES DEPARTMENT JRH DATE REQUESTED 11-20-95

IF YOUR DEPARTMENT HAS ANY INFORMATION - PLEASE SIGN, DATE, AND ATTACH TO THIS FORM FOR OUR RECORDS.

DOES THIS SITE HAVE AN APPROVED SYSTEM FOR THE ABOVE REQUEST ?

YES  NO \_\_\_\_\_

REMARKS: Site has an approved system designed to accomodate a three (3) bedroom residence. See attached sheet.

HEALTH DEPARTMENT SIGNATURE Julius Nwaokolo DATE 11/20/95

FIRST VISIT   
 SUBSEQUENT VISIT   
 UNKNOWN

INSTALLATION OR REPAIR RECORD OF SEPTIC TANK SYSTEM

Residence  
 TYPE OF ESTABLISHMENT

OWNER Sherrill Anderson ADDRESS Patterson Rd.

LOCATION \_\_\_\_\_ CIVIL DISTRICT \_\_\_\_\_


OCCUPANT \_\_\_\_\_ ADDRESS \_\_\_\_\_

TANK: TYPE concret LIQUID CAPACITY (GALS.) 1000

FIELD LINE: LINEAR FEET OF TILE 487 WIDTH OF TRENCH 24 LENGTH OF TRENCH 987

DEPTH OF TRENCH 24 DEPTH OF STONE 12 GARBAGE GRINDER PROPOSED: YES ( ) NO ( )

SKETCH OF SYSTEM: BY Tom Yates DATE 3-7-72 INSTALLED BY Seaton

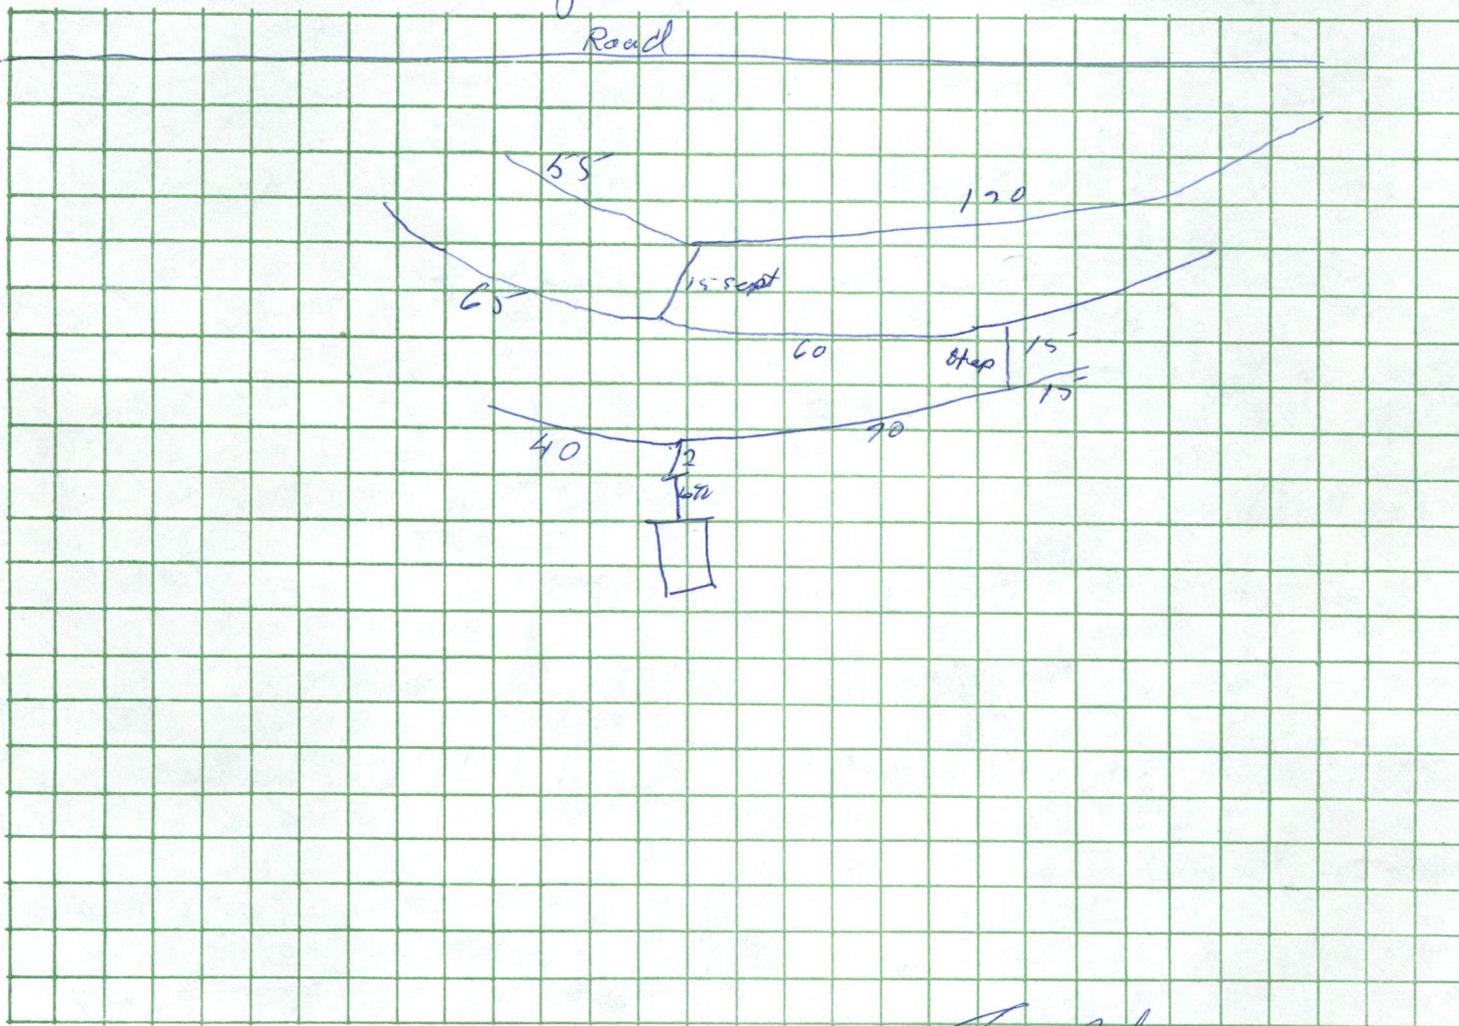

FINAL APPROVAL: YES ( ) NO ( ) DATE 3-7-72 Tom Yates  
 SIGNATURE

REMARKS: 3-1-72 - not complete - T's not sealed and tight line monitored  
doors not removed

NOTE: Plumber must notify the \_\_\_\_\_ Health Department (Phone \_\_\_\_\_) when the septic tank system is ready for inspection. If any septic tank system or part thereof is covered before being regularly inspected and approved, it shall be uncovered by the plumber at the direction of the Health Officer or his authorized representative.

## SOIL IDENTIFICATION AT SEPTIC TANK DISPOSAL FIELD SITE

NAME: SHERILL ANDERSON

ADDRESS: RT #1 PATTERSON RD

Date	Location	Soil	Approved	Rejected	Percolation Test Required
	Go Hwy 96 PAST Bill Rice Ranch. TAKE FIRST GRAVEL ROAD TO LEFT	Bradsville (Deep) ↓			
	STOP AT FIRST TRAILER ON RIGHT. ASK AT TRAILER FOR SITE. MR. BEST AT TRAILER	Jc. Ince USDA Soil Scientist			

COMMENTS: TRAILER ↓ Mr Best was present and knows location of site selection Jc



ENVIRONMENTALIST J.F.

# PERMIT FOR CONSTRUCTION OF INDIVIDUAL SEWAGE DISPOSAL SYSTEM

Rutherford County Health Department

Issued to: SITERRIL ANDERSON  
(OWNER OR DEVELOPER)

to be constructed by: F. HENRY  
(PLUMBER OR CONTRACTOR)

Construction of an individual sewage disposal system consisting of a septic tank and underground tile disposal field, or \_\_\_\_\_ is hereby authorized at \_\_\_\_\_

RT # 1 PATTERSON ROAD.  
(OTHER APPROVED SYSTEM) (PROPERTY ADDRESS -  
NO. AND STREET, SUBDIVISION NAME AND LOT NO., ETC.)

Such system shall be constructed in accordance with the rules and regulations and specific instructions of the Health Department and shall consist of a septic tank of 1000 gallons liquid capacity with 495 linear feet of field tile in \_\_\_\_\_ trenches 24 inches wide and 24-36 inches deep, or 12" Rock  
(DESCRIPTION OF OTHER APPROVED SYSTEM)

No part of the system is to be within 100 feet of a well water supply and no part of system is to be covered with soil until it has been inspected and approved by an appropriate Health Department representative.

Issued at M'Boon, Tennessee, this 7 day of Feby, 1974.

3 Bed Room

James H. Gaby, Sanitarian  
TENNESSEE DEPARTMENT OF PUBLIC HEALTH - 306