

Pd. 3000
3/13/87

John S.

1. Service Requested: Septic System Permit _____ Reinspection Letter Water Sample _____

2. Landowner: Name Ira Carpenter Applicant: Name Marcella Erickson Original Owner: Name Barry Edwards
Address Lot 15 Fox Ridge Dr. Address 1814 Avon Rd. Blder

Phone # 893-4972 Phone # 893-4372

3. Is the lot in a subdivision? Yes Name Fox Ridge Lot # 15
If not in subdivision, give specific directions: _____

Map Number _____ Parcel Number _____

4. For reinspection letter only: Will pick-up Please mail _____
a) Age of house 1 1/2 yrs. b) Is house vacant? No How long? _____
c) Original sewage system inspected by health department? Yes
d) Date of previous repairs None inspected? 1 1/2 yrs. ago
e) Waste water "backing up" into plumbing fixtures? No surfacing on the ground? No
f) All waste water including washing machines routed into septic tank? Yes

5. For water sample only: a) Is there an outside faucet? _____ b) Sanitary seal on the casing? _____
c) Is the well chlorinated? _____ d) Casing 6 inches above ground? _____

6. For SSD Permit only: a) Size of Lot _____ b) Number of Bedrooms _____
c) How many occupants _____ d) Basement Plumbing: Yes _____ No _____
If yes, it will be washing machine _____ bathroom _____ other _____
e) Amount of water used monthly (gallons) _____
f) Water: Public _____ Well _____ Spring _____
g) Is the lot staked? _____ Is the house site staked? _____
h) Installer if known: _____

7. Make a rough sketch on the back of this page showing property lines, house site, well location planned driveway and utilities.

8. ALL FEES ARE DUE IN ADVANCE AND ARE NON-REFUNDABLE.
Septic System permit \$50.00 up to 1000 gpd Reinspection letter \$30.00
\$10.00 each additional 1000 gpd 30 working days required
Water Samples: total coliform \$20.00
fecal coliform \$25.00

9. I certify that the above information is true and correct to the best of my knowledge.
Date 3/12/87 Signature Marcella Erickson

Receipt No. _____

PERMIT FOR CONSTRUCTION OF SUBSURFACE SEWAGE DISPOSAL SYSTEM

83676

Issued to: Barry Edwards
Owner, Developer, Contractor, Installer, Etc.

REGION	COUNTY	ID-NUMBER	DATE
<u>5</u>	<u>75</u>		<u>8-20-85</u>

To be constructed by Rolly Todd
(Installer)

STAFF	INSTALLATION:
<u>103</u>	<input checked="" type="checkbox"/> 1. New Installation <input type="checkbox"/> 2. Repair to Existing System

Construction of a subsurface sewage disposal system is hereby authorized at:
Joxridge Sec. II lot # 15
(No. and street; Subdivision name and lot no.)

Type of System:
<input checked="" type="checkbox"/> 1. Standard <input type="checkbox"/> 2. Alternating <input type="checkbox"/> 3. Chapter 301 <input type="checkbox"/> 4. Chapter 212 <input type="checkbox"/> 5. Other
For:
<input checked="" type="checkbox"/> 1. Residential: No. B/R <u>three</u> <input type="checkbox"/> 2. Commercial/Industrial; Gal/Day _____

Such a system shall consist of a septic tank of 1000 gals.
with 300 linear feet in _____ trenches,
36 inches wide, and 24-36" deep
or 45 ton of rock


Evaluation based Upon:
<input checked="" type="checkbox"/> 1. Soil Typing by Soil Scientist <input type="checkbox"/> 2. Soil Percolation Tests <input type="checkbox"/> 3. Other
Permeability Rate
<u>45 mpi</u>

The recipient of this permit agrees to construct or have constructed the system in accordance with the rules and regulations under the authority of TCA 53-2054. The recipient must notify the local health authority when the system is ready for inspection. If any part of system is covered before being inspected and approved, it shall be uncovered by the recipient of the permit at the direction of the local health authority.

Barry Edwards Date 7-8-85
(Signature of Recipient-Owner, Developer, Contractor, Etc.)

Issued at Markeeboro, Tennessee in the County of Rutherford
By Ronald E. Bolin Date 6-25-85
(Local Health Authority)

To be installed in rear of lot.
Driveway and water line on North side of lot.

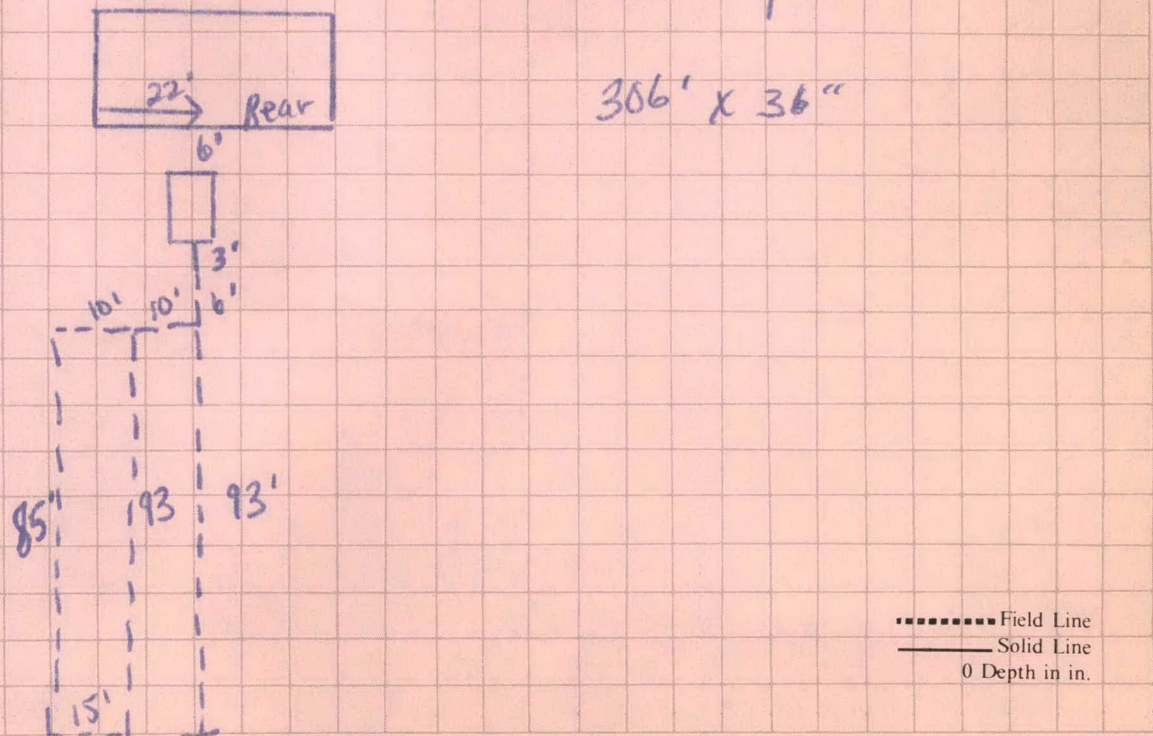

Inspected By Ron Bolin
Local Health Authority
Date 8-20-85

Construction Approval: 1. Yes 2. No

040

No. of Visits: 2 Time



TENNESSEE DEPARTMENT OF HEALTH AND ENVIRONMENT
 MARCH 25, 1987

Dear

On MARCH 24, 1987, an investigation of the subsurface sewage disposal system, which does not include plumbing and other fixtures preceding the septic tank, was performed at FOX RIDGE S/D LOT # 15 (city) (county)

At the time of the investigation the following observation(s) were made: (city) (County)

- There was no evidence of sewage or effluent outcropping to the ground surface.
- Sewage or effluent from the sewage system was outcropping to the ground surface.
- The house appears vacant; therefore, the performance of the sewage system, when typically loaded, can not be realistically evaluated.

A thorough search of our files indicate the following:

- The sewage system was inspected and approved by a representative of this Department. The system was designed on an estimated absorption rate of 45 minutes per inch or a percolation rate of _____ minutes per inch.
- The sewage system was inspected and disapproved by a representative of this Department.
- No record of the site evaluation could be found.
- No record of the sewage system construction or approval could be found.
- The site was evaluated on _____ and determined unfavorable for subsurface sewage disposal.
- A repair was attempted to the subsurface sewage disposal system on _____. These modifications do _____ do not _____ meet the minimum standards of this Department.

Remarks:

If you have any questions or comments concerning the contents of this letter, please feel free to contact me at 893-4422.

Sincerely,

Division of Ground Water Protection

SG/Hold I

PH-2790
6/86