
- WELL #2 -

SURRY COUNTY HEALTH & NUTRITION CENTER

Well Certificate of Completion



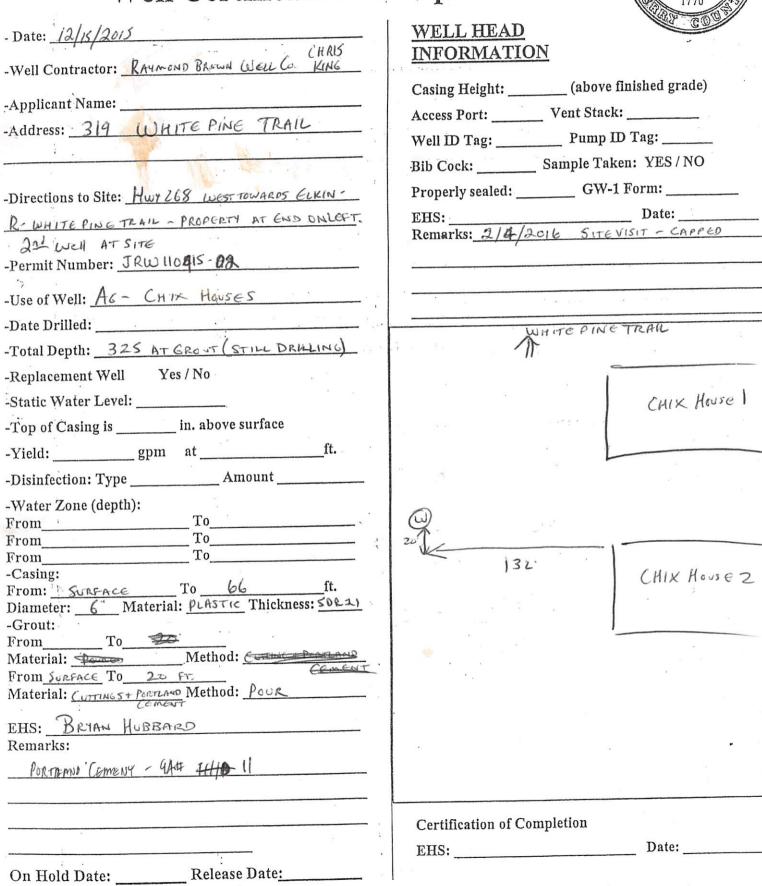

Non Residential well construction record

North Carolina Department of Environment and Natural Resources-Division of Water Quality

WELL CONTRACTOR CERTIFICATION # 2312

1. WELL CONTRACTOR:	d. TOP OF CASING IS 1 FT. Above Land Surface*	
Chris Bullins	*Top of casing terminated at/or below land surface may remaine	
Well Contractor (Individual) Name	a variance in accordance with 15A NCAC 2C .0118.	
raymond Brown Well Company, Inc.	e. YIELD (gpm): 50 METHOD OF TEST sight	
Well Contractor Company Name	f. DISINFECTION: Type Hth Amount 16 oz	
STREET ADDRESS 1109 N Main Street	g. WATER ZONES (depth):	
	From 70 To 72 From To	
Danbury NC 27016 City or Town State Zip Code	- From 350 To 351 From To	
(336) 593-8239	From 740 To 742 From To	
Area code- Phone number 2. WELL INFORMATION:	7. CASING: Depth Diameter Thickness/Weight Material	
SITE WELL ID #(if applicable)	From 0 To 66 Ft 61/4 sdr 21 pvc	
WELL CONSTRUCTION PERMIT#(if applicable) BEH090315-01	FromToFt	
OTHER ASSOCIATED PERMIT #(if applicable)	ToToFt	
3. WELL USE (Check Applicable Box) Manitoring Municipal/Public	8. GROUT: Depth Material Method	
Industrial/Commercial Agricultural Recovery Injection	From 0 To 20 Ft. cement pour	
frrigation Other (list use)	FromToFt	
DATE DRILLED 12-18-15	FromToFt	
TIME COMPLETED 3:00 AMD PMD	9. SCREEN: Depth Diameter Slot Size Material	
4. WELL LOCATION:	FromToFtininin.	
CITY: COUNTY Surry	FromToFtinin	
	From To Ft in in	
(Street Name, Numbers, Community, Subdivision, Lot No., Parcet, Zip Code) TOPOGRAPHIC / LAND SETTING: Slope Valley Flat Ridge Other (check appropriate box)	10. SAND/GRAVEL PACK: Depth Size Material From To Ft.	
I May be in degrees	FromToFt	
LATITUDE minutes, seconds or in a decimal format	FromToFt	
LONGHODE	11.DRILLING LOG	
Latitude/longitude source: GPS Topographic map (location of well must be shown on a USGS topo map and attached to this form if not using GPS)	From To Formation Description	
5. FACILITY- is the name of the business where the well is located.	0 25 Red Clay	
FACILITY ID #(if applicable)	25 60 Sand Rock	
NAME OF FACILITY	60 805 Blue Granite	
STREET ADDRESS	55 1 005 Bibe Grante	
City or Town State Zip Code		
CONTACT PERSON Eddie Shumate		
MAILING ADDRESS		
City or Town State Zip Code	12. REMARKS:	
Area code - Phone number		
6. WELL DETAILS:	I DO HÉREBY CERTIFY THAT THIS WELL WAS CONSTRUCTED IN ACCORDANCE WITH	
a. TOTAL DEPTH: 805	15A NCAC 2C, WELL CONSTRUCTION STANDARDS, AND THAT A COPY OF THIS	
h DATA HELL DEBY AND THE PARTY OF THE PARTY	RECORD HAS BEEN PROVIDED TO THE WELL OWNER.	
	SIGNATURE OF CERTIFIED WELL CONTRACTOR DATE	
c. WATER LEVEL Below Top of Casing: 60 FT. (Use *+" if Above Top of Casing)	Chris Bullins	
	PRINTED NAME OF PERSON CONSTRUCTING THE WELL	

Submit the original to the Division of Water Quality within 30 days. Attn: Information Mgt., 1617 Mail Service Center - Raleigh, NC 27699-1617 Phone No. (919) 733-7015 ext 568.

Form GW-1b Rev.12/07

SURRY COUNTY HEALTH AND NUTRITION CENTER WELL CONSTRUCTION PERMIT



If the information on this Well Construction Permit is falsified, changed, or if the site is altered, then the Well Construction Permit shall become invalid.

Applicant's Name: Eddie Shumate PIN: 4893-00-38-7066 Permit Number: JRW110415-02

Site Address: 319 White Pine Trl
Subdivision: Lot Number:

Directions to Site: Hwy 601S T/R Hwy 268 T/R White Pine Trl, site on L

EHS Name: Justin White Date Issued: 11/05/2015 Expires: 11/05/2020

Authorized State Agent:

Date: 11/5/2015

WHITE PINE TRL

A98300387066

A98300387066

APRIL APRI

Facility Served: Agriculture/ Chicken Houses

<u>PERMIT SPECIFICATIONS:</u> Honor all setbacks; Must be >100' from any animal barn, >50' from any other potential sources of groundwater contamination

- *This permit is for one single well
- *This permit is valid until the date listed above OR until the well is grouted, whichever comes first.
- *I understand that once the well is completed, I must contact the Surry County Environmental Health Department for the final well head inspection.
- *I have reviewed and hereby approve of this Well Construction Permit. I will contact the Surry County Environmental Health Department if there is a relocation of the proposed facility, a change in the intended use of the facility, a need for the installation of a waste water system in an area other than indicated on the well permit, or if there are any landscaping changes that may affect site drainage prior to the construction of the well. I accept the specifications of this permit.

Applicant or Legal Representative Signature	Date	