

Permit Type: Septic Record

CERTIFICATE OF COMPLETION

Вогуски, Аллен Н.

Property Owner: _____ Address: _____


Location of Property: _____

Sub-Division Lot No. 17

Precast Yes ☒ No ☐ Capacity 900 gallon

Type Secondary Treatment: Nitrification Line ☒ Square Footage 750' Length of Lines 150' Width 5'

Number of Lines 1 Installed By: Medford Owens

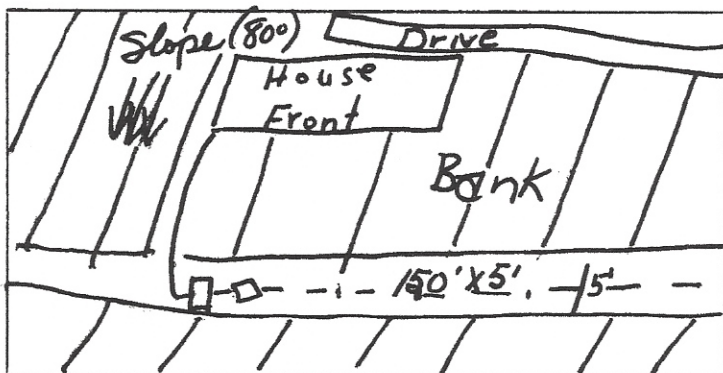

Designed For Use For:

☐ **Commercial Building:** Type

☐ Residence: Number Bedrooms

Basement: Yes ☐ No ☒

Automatic Washer: Yes ☒ No ☐

Garbage Grinder: Yes ☐ No ☒

Well Permit Issued: Yes ☐ No ☒

Source of Water Supply: Megge San

Remarks: (1) 10' gravel (3) Extra wide

(3) line:

Approved: Yes ☒ No ☐

Sanitarian Steve Miller

Date August 26, 1977 Imp. Permit No. JRV-23

Haywood County Health Department

NOTE—This approval is issued subject to all the provisions of the Board of Health governing the installation of septic tanks or plumbing in unsewered areas of Haywood County. No plumber or other person is permitted to make any alteration other than that which is specifically stated in this approval.